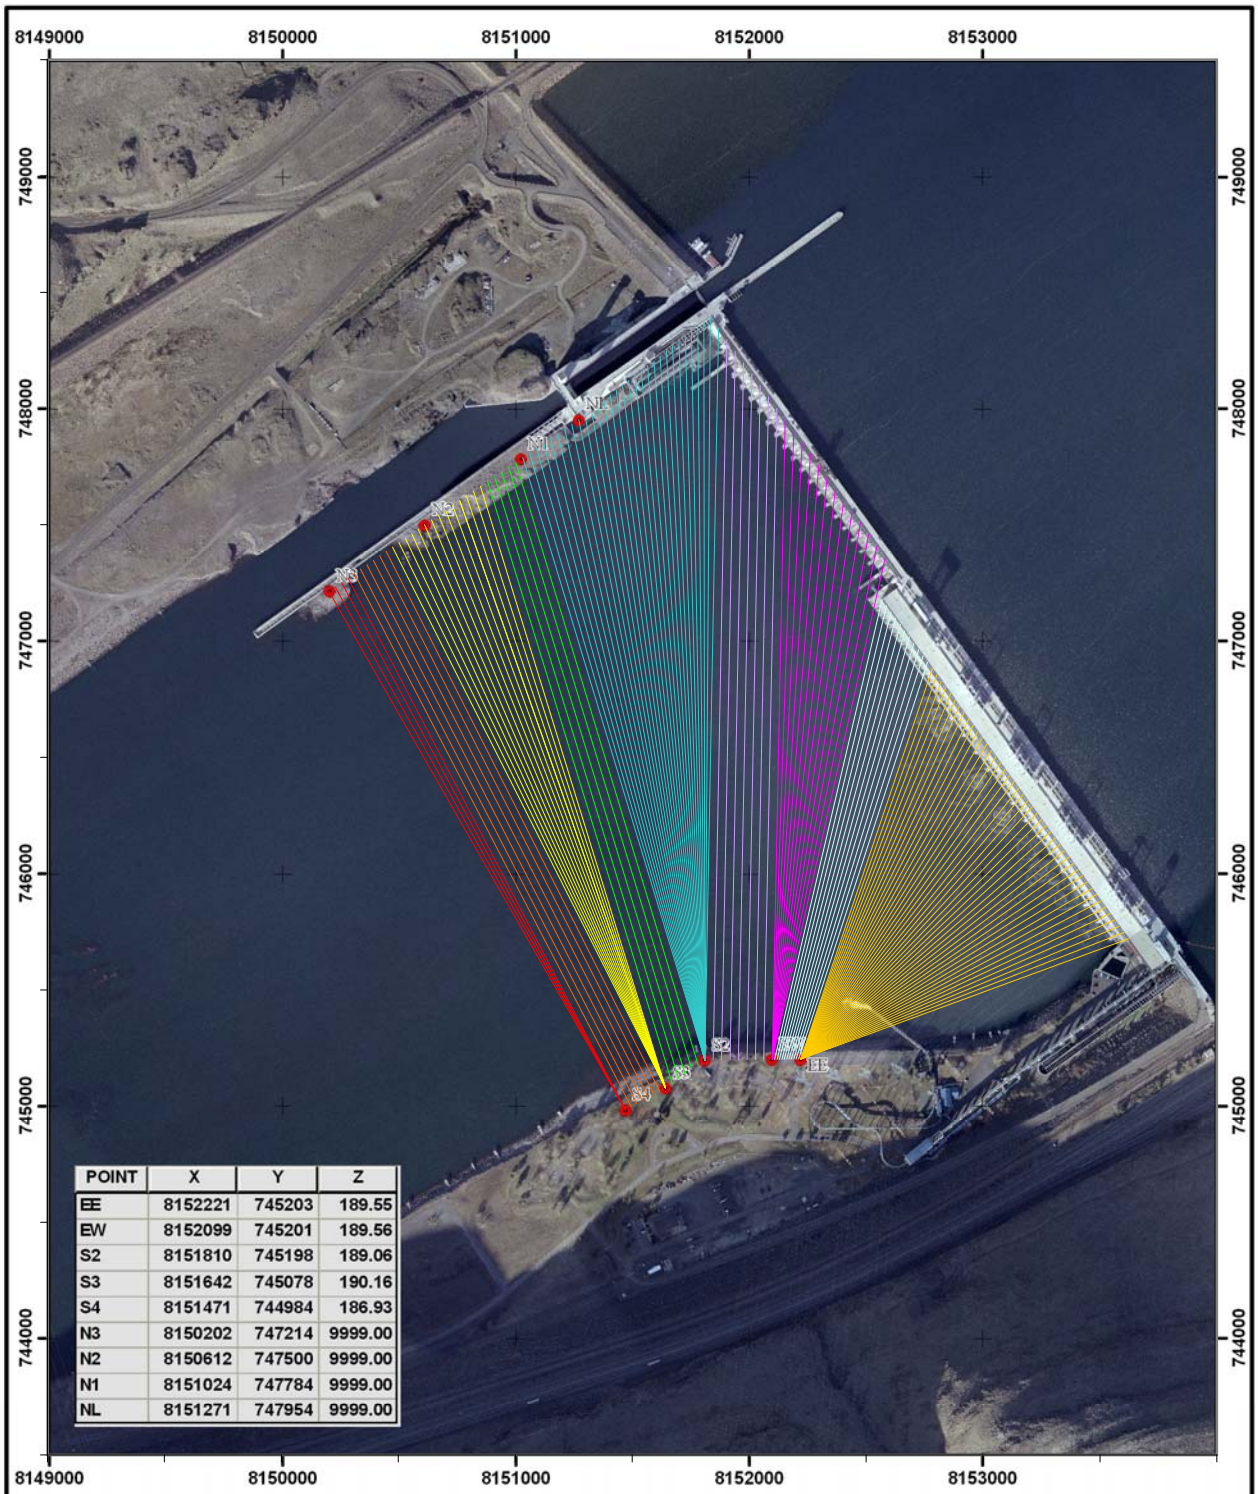

POINT	X	Y	Z
EE	8152221	745203	189.55
EW	8152099	745201	189.56
S2	8151810	745198	189.06
S3	8151642	745078	190.16
S4	8151471	744984	186.93
N3	8150202	747214	9999.00
N2	8150612	747500	9999.00
N1	8151024	747784	9999.00
NL	8151271	747954	9999.00

JOHN DAY AVIAN WIRE SUPPORT POLE LOCATIONS

0 500 1,000

Scale in feet

Projection: NAD83 SPCS OR North, U.S. Survey Feet